



SURVEY RECORD DRAWING

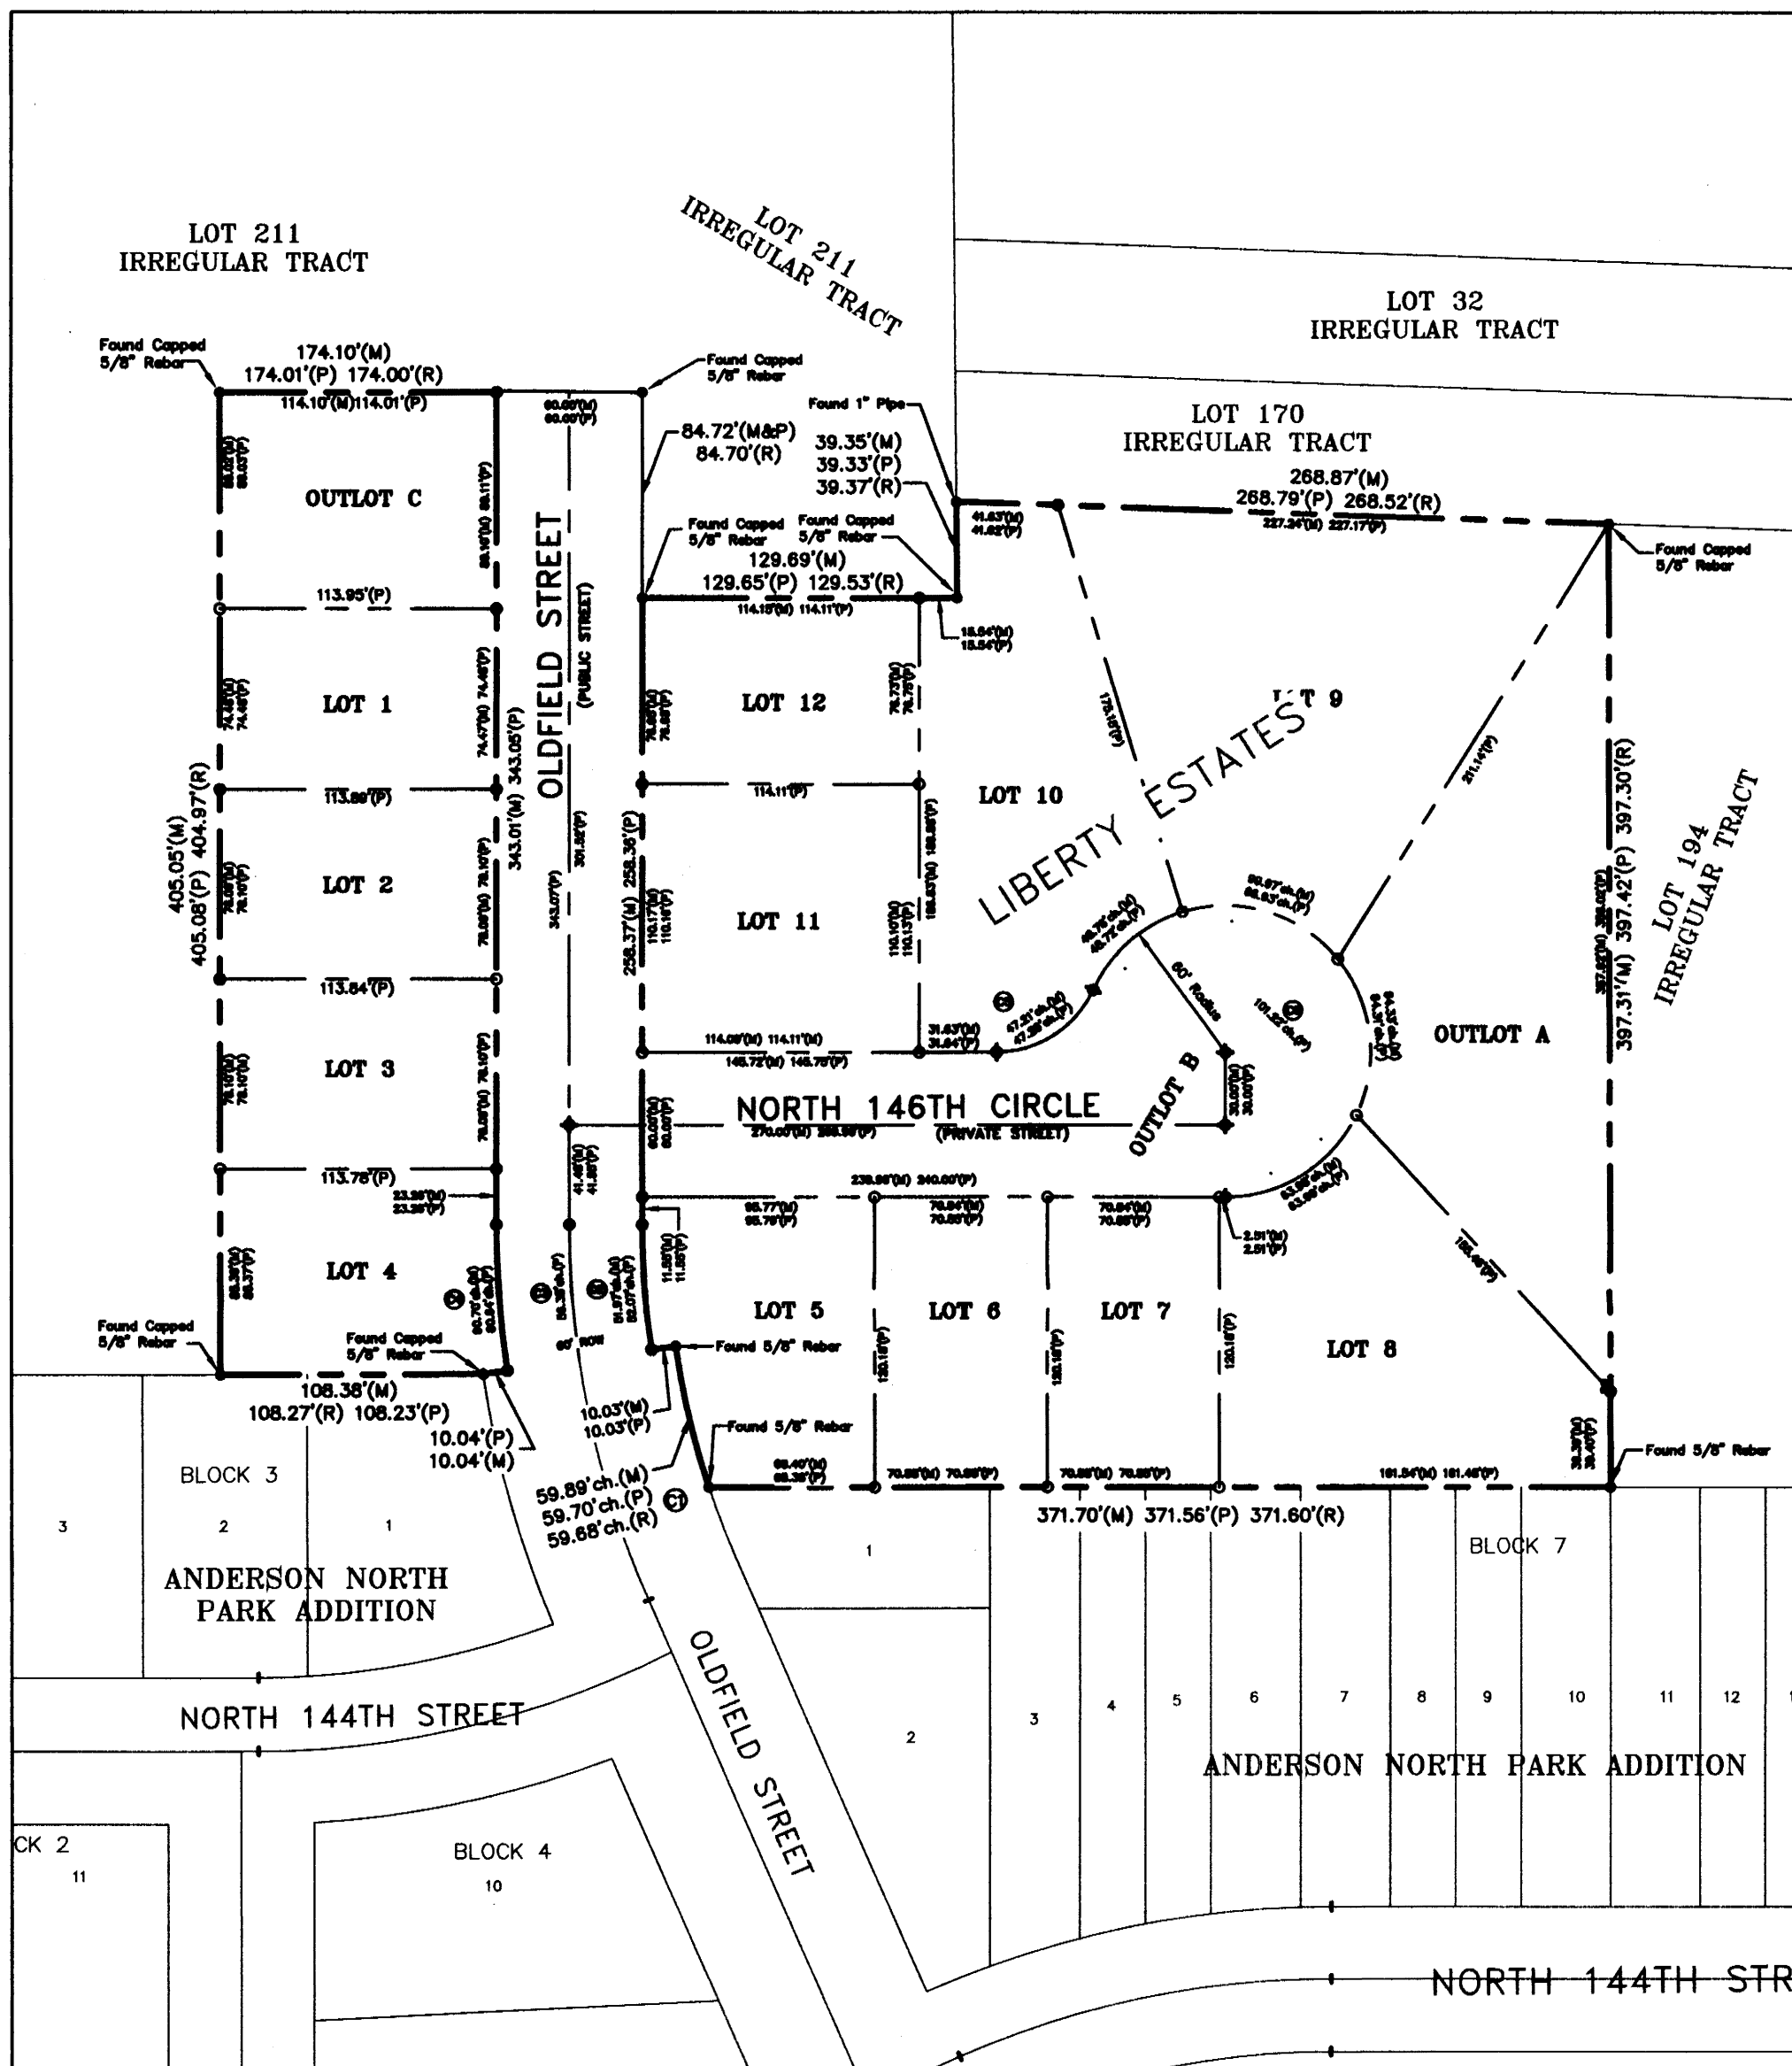

NORTH
SCALE 1" = 70'

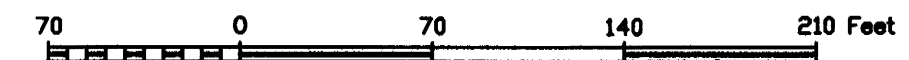


LEGAL DESCRIPTION

LOTS 1, 2, 3, 4, 5, 6, 7, 8, 9, 10, 11, 12, OUTLOT A, OUTLOT B AND OUTLOT C, FINAL PLAT LIBERTY ESTATES, WAVERLY, LANCASTER COUNTY, NEBRASKA.

LAND SURVEYOR'S CERTIFICATE

THIS IS TO CERTIFY THAT THIS SURVEY WAS DONE BY THE UNDERSIGNED, THAT THE SURVEY WAS DONE ON THE GROUND IN ACCORDANCE WITH THE MOST RECENT MINIMUM STANDARDS FOR PROPERTY BOUNDARY SURVEYS, AS SET FORTH BY THE NEBRASKA STATE BOARD OF EXAMINERS FOR REGISTERED LAND SURVEYORS AND THAT THE ACCURACY SPECIFICATION AND POSITION TOLERANCE ARE IN ACCORDANCE WITH RURAL AREA SURVEYS. THAT IRON MARKERS WERE PLACED AT ALL CORNERS AS SHOWN ON THE PLAT.

DATE: July 28, 2011



MARK A. SMITH, P.E. LS-520
1620 SOUTH 70TH STREET, SUITE 103
LINCOLN, NE 68506
(402) 484-7342
REGA#091083

SURVEY RECORD REPOSITORY
RECEIVED
JUL 28 2011
\$ 250
County Lancaster
1029-215

CURVE DATA

CURVE #	DELTA	RADIUS	LENGTH	TANGENT	CHORD DISTANCE
C1	10°08'20"	340.00	59.97	30.06	59.89
C2	8°30'56"	350.00	52.02	28.08	51.97
C3	8°30'18"	380.00	58.41	28.26	56.35
C4	8°29'25"	410.00	60.76	30.43	60.70
C5	8°43'18"	44.00	49.83	27.97	47.21
C6	24°58'16"	60.00	256.53	94.23	101.22
C7	90°00'00"	10.00	15.71	10.00	14.14
C8	90°00'00"	40.00	62.83	40.00	56.57
C9	90°00'00"	60.00	94.25	60.00	84.85
C10	90°00'00"	90.00	141.37	90.00	127.28

REGA ENGINEERING GROUP, INC.
1620 SOUTH 70TH STREET
SUITE 103
LINCOLN, NE 68506
402-484-7342 OFFICE
402-484-7344 FAX

JOB NAME: EXCEL DEVELOPMENT
LOCATION: WAVERLY, NEBRASKA.

DRAWN BY: MAS
CHECKED BY: MAS

SCALE: 1" = 70'

DATE: 12/31/2010

DESCRIPTION: LOT STAKING

JOB NUMBER: 091083

SHEET: 1 OF 1

REGA
ENGINEERING
GROUP, INC.

1620 SOUTH 70TH ST., SUITE 103
LINCOLN, NEBRASKA 68506
(402) 484-7342

• ENGINEERING
• PLANNING
• LAND SURVEYING